Wednesday, 2/20/2008 4:18:07 PM Date: Kim Johnston **Process Sheet** : CU-DAR001 Dart Helicopters Services **Drawing Name** : BASKET BASE ASSEMBLY (350) Customer : 37513C Job Number اد.ده. ده الم : 10189 **Estimate Number** : D2221 P.O. Number Part Number : D2221 U/R, D2235 : 2/20/2008 S.O. No. : **Drawing Number** This Issue : N/A Prsht Rev. : NC Project Number ; F/B1 : 11 : LARGE FAB ASSY First Issue Type **Drawing Revision** : 37512C Previous Run Material **Due Date** : 3/15/2008 Qty: 1 Um: Each Written By Checked & Approved By Added D3442-1 KJ/JLM : Est Rev: 05.09.02 Comment **Additional Product** Job Number: Seq. #: Machine Or Operation: Description: 1.0 D31661 Basket Hoop Comment: Qty.: 4.0000 Each(s)/Unit Total: 4.0000 Each(s) Pick: Qty Part Number Description Batch 04 011 D3166-1 **RIB** 2.0 D22323 Basket Hinge Comment: Qty.: 2.0000 Each(s)/Unit Total: 2.0000 Each(s) Pick: **Qty Part Number** Description Batch 2 D2232-3 Hinge bracket <u>\$36846</u> 04 01 3.0 D2325 Support Gusset (350 Bask Comment: Qty.: 4.0000 Each(s)/Unit Total: 4.0000 Each(s) Pick: **Qty Part Number** Description 4 D2325 Support Gusset FC 08 04 01 4.0 D23273 Spacer Bushing Comment: Qty.: 2.0000 Each(s)/Unit Total: 2.0000 Each(s) Pick: **Qty Part Number** Description 2 D2327-3 Bushing

Dart Ae	rospace L	td		•					
W/O:			W	ORK ORDER CHANGE	S			,	
DATE STEP			PROCEDURE CHANGE			Date	Qty	Approval Chief Eng / Prod Mgr	Approval QC Inspector
	-								
				·					
Part No:		PAR #:	Fault Cate	gory:	NCR: Yes	No <b>DQ</b>	A:	Date: _	
					QA: N	/C Close	d:	_ Date: _	
NCR:			WORK ORD	ER NON-CONFORMA	NCE (NCR	3)		, <del></del> .	
		Description of NC	Corrective Action Section B		n B	Verifi	fication	Approval	Approval
DATE	STEP Description of NC Section A		Initial Chief Eng	Action Description Chief Eng	Sign & Date	Section C		Chief Eng	QC Inspector
						!	,		

NOTE: Date & initial all entries

Wednesday, 2/20/2008 4:18:08 PM Date: Uŝer: Kim Johnston **Process Sheet** Drawing Name: BASKET BASE ASSEMBLY (350) Customer: CU-DAR001 Dart Helicopters Services Job Number: 37513C Part Number: D2221 Job Number: Seq. #: Description: Machine Or Operation: D2581 Mounting Bracket Comment: Qty.: 2.0000 Each(s)/Unit Total: 2.0000 Each(s) Qty Part Number Description Batch C 08 04 01 Mounting Bracket 1537248 6.0 D34421 Comment: Qty.: 2.0000 Each(s)/Unit Total: 2.0000 Each(s) Pick: Qty Part Number Description Batch 034610 2 D3442-1 Shim FC 0804 01 7.0 M304EX07516F Expanded Metal Flat Stai Comment: Qty.: 41.6745 sf(s)/Unit Total: 41.6745 sf(s) Pick: Qty Part Number Description Batch 39.69 sf M304EX0.75-16F Expanded Metal <u>M107511</u> 8.0 Comment: Qty.: 29.4000 f(s)/Unit Total: 29.4000 f(s) ا 2. دن. في المحم كان ن Pick: 28' 3/4" x 3/4" x <del>0.063 wall 304/316 SStubing</del> Batch: M 107514 LARGE FAB LARGE FABRICATION RESOURCE 1 Comment: LARGE FABRICATION RESOURCE 1 1-Cut D2235-1 Rib from D3166-1 Rib As Per Dwg D2235 / 2-Drill hole in D2221-3 as per Dwg D2221 3-Deburr FC 4-Remove all markings on material before welding 5-Weld as per Dwg D2221 using Welding Table and corner JigDeburr as required

Page 2

Form: infocess

Dart Ae	rospace Li	td		·					
W/O:			WC	RK ORDER CHANGE	S				
DATE	STEP	PROCEDURE CHANGE			Ву	Date	Qty	Approval Chief Eng / Prod Mgr	Approval QC Inspector
· · · · · · · · · · · · · · · · · · ·				· · · · · · · · · · · · · · · · · · ·			:		
Part No	:	PAR #:	Fault Cate	gory:					
					QA: N	I/C Close	d:	_ Date: _	
NCR:			WORK ORDI	ER NON-CONFORMA	NCE (NCI	र)			
		Description of NC		Corrective Action Section	ı B	Verifi	cation	Approval	Approval
DATE	STEP	Section A	Initial Chief Eng	Action Description Chief Eng	Sign of Date	Sect	ion C	Chief Eng	QC Inspector
						-			
							<del></del>		

NOTE: Date & initial all entries

Date: User: Wednesday, 2/20/2008 4:18:08 PM

Kim Johnston

**Process Sheet** 

Customer: CU-DAR001 Dart Helicopters Services

Drawing Name: BASKET BASE ASSEMBLY (350)

Job Number: 37513C

Part Number: D2221

Job Number:



Seq. #:

Machine Or Operation:

Description:

10.0

QC9

VISUAL WELDING INSPECTION





11.0

QC6

DIMENSIONAL CHECK



Comment: DIMENSIONAL CHECK

POWDER COATING

POWDER COATING



12,0

Comment: POWDER COATING


Powder Coat White Gloss (Ref: 4.3.5.1) as per QSI 005 4.3

13.0 QC3



Comment: INSPECT

POWDER COAT/CHEMICAL CONVERSION

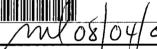

14.0

QC21

FINAL INSPECTION/W/O RELEASE



Job Completion





Dart Ae	rospace L	td								
W/O:	T		WC	ORK ORDER CH	ANGES					
DATE STEP		PROCEDURE CHANGE			Ву	Date	Qty	Approval Chief Eng / Prod Mgr	Approval QC Inspector	
										The state of the s
Part No		PAR #:	Fault Cate	gory:	NC	R: Yes	No DQ	A:	Date:	
									Date:	
NCR:		'	WORK ORD	ER NON-CONFO	RMANCE	E (NCF	2)			
DATE	STEP	Description of NC Section A	Initial Chief Eng	Corrective Action Action Descrip	Section B	Sign 8	Verification Section C		1	Approval QC Inspector
			Official Eng	Office Ling		Date				
										f

NOTE: Date & initial all entries



	DESIG	вW	DRAWN BY	DART AEROSPACE LTD HAWKESBURY, ONTARIO, CANADA	
	CHEC	KED!	APPROVED 41	DRAWING NO. REV	/. F
		4	#	D2221 SHEET 1 0	F 3
ļ	DATE			TITLE SC	ALE
	05.0	6.07		BASKET BASE ASSEMBLY (350)	NTS
	O		95.11.21	SEPARATE BASKET AND LID	
	D		96.06.21	CHANGE LATCH	
ļ	Ε		01.04.19	CHANGE HINGE	
	F		05.06.07	ADD SHIM UNDER HINGES, ADD HOLES FOR SPLIT LID BASKETS	3

RELEASED 05.08.19 4

## PARTS LIST FOR D2221 BASKET BASE ASSEMBLY

			<del>r</del>	
PART NO	QUANTITY	LENGTH	LENGTH	DESCRIPTION
		Α	В	
D2221-1	2		96.00	RIB
D2221-3	2		25.50	RIB
D2221-5	2	18.88		RIB
D2221-7	1	55.25	<u> </u>	RIB
D2232-3	2	N/A	N/A	HINGE PLATE
D2235-1	4	N/A	N/A	RIB
D2325	4	N/A	N/A	SUPPORT GUSSET
D2327-3	2	N/A	N/A	BUSHING
D2581	2	N/A	N/A	MTG BRKT
D3442-1	2	N/A	N/A	SHIM

ENGINEERING 45 UNCONTROLLED COPY SUBJECT TO AMENDMENT

D2221-1/-3/-5/-7

QUT LENGTH/SHAPE PER DIAGRAM AND PARTS LIST 1)


MATERIAL: AISI 304/316 SS, 3/4 X 3/4 X 0.060 WALL SQUARE TUBING 2) (REF. DART SPEC M304TS0.750W.060) ~ 0.065 P4 01.02.31

- 3) TOLERANCES ARE PER DART QSI 018 UNLESS OTHERWISE NOTED
- 4) ALL DIMENSIONS ARE IN INCHES
- DRILL Ø0.257 HOLES ONLY WHEN ASSEMBLING D2221 BASE WITH D2989-041/-043 BASKET LID

Copyright © 1994 by DART AEROSPACE LTD


THIS DOCUMENT IS PRIVATE AND CONFIDENTIAL AND IS SUPPLIED ON THE EXPRESS CONDITION THAT IT IS NOT TO BE USED FOR ANY PURPOSE OR COPIED OR COMMUNICATED TO ANY OTHER PERSON WITHOUT WRITTEN PERMISSION FROM DART AEROSPACE LTD.

The state of the s	the state of the s			•	i	
		*				
		•		•	•	
				·		
			•			*, }
				·		:
rg -						
	::2					
e de la companya de l						
* <sup>*</sup>						
	•					
					_	
					د	
	Principle of the Control of the Cont					

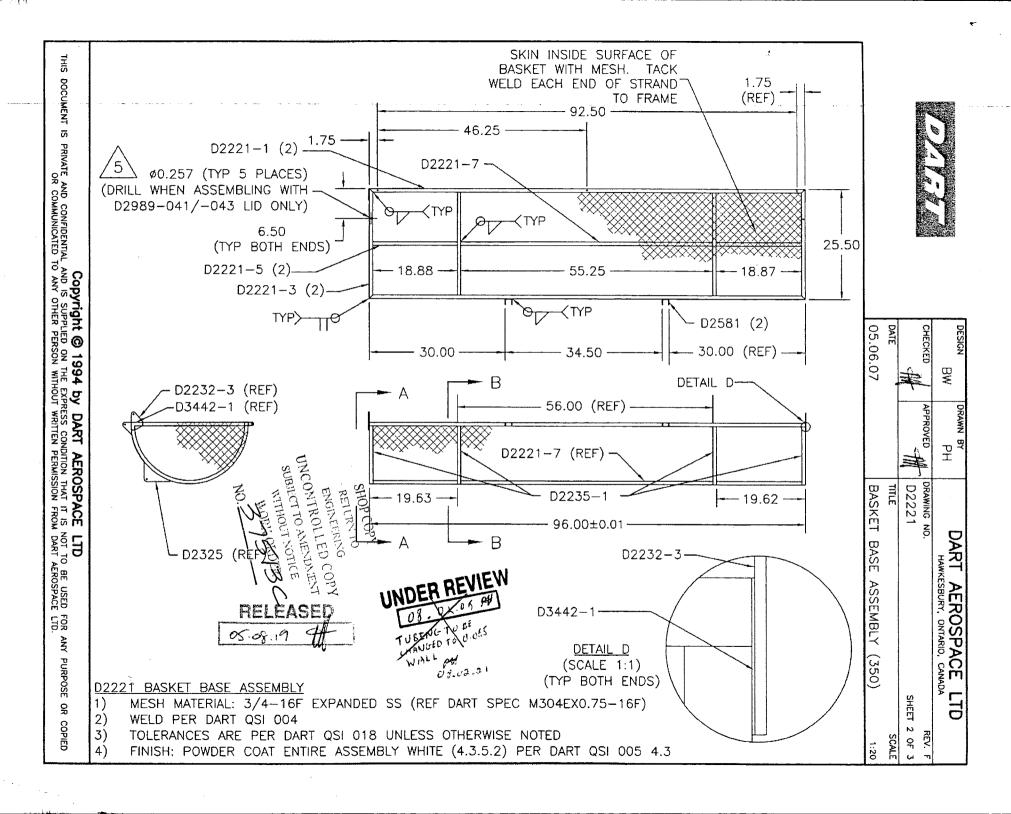





DESIGN BW	DRAWN BY	DART AEROSPACE LT HAWKESBURY, ONTARIO, CANADA	D
CHECKED	APPROVED	DRAWING NO.	REV. F
一世	- THE	D2221 shi	EET 3 OF 3
DATE	1	TITLE	SCALE
05.06.07		BASKET BASE ASSEMBLY (350)	1:8

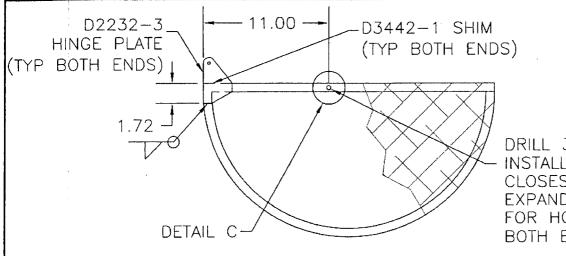

DRILL 3/8 HOLE AND INSTALL D2327-3 USING CLOSEST SPACE IN EXPANDED METAL FOR HOLE LOCATION BOTH ENDS

## SECTION A-A SAME BOTH END RIBS

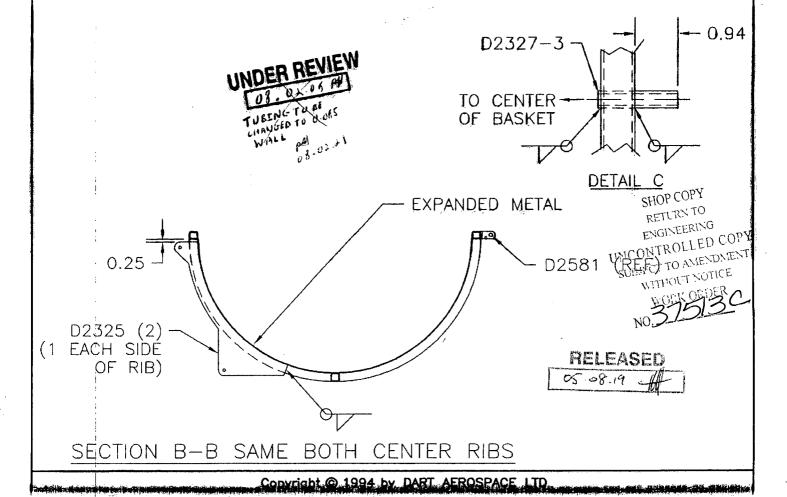

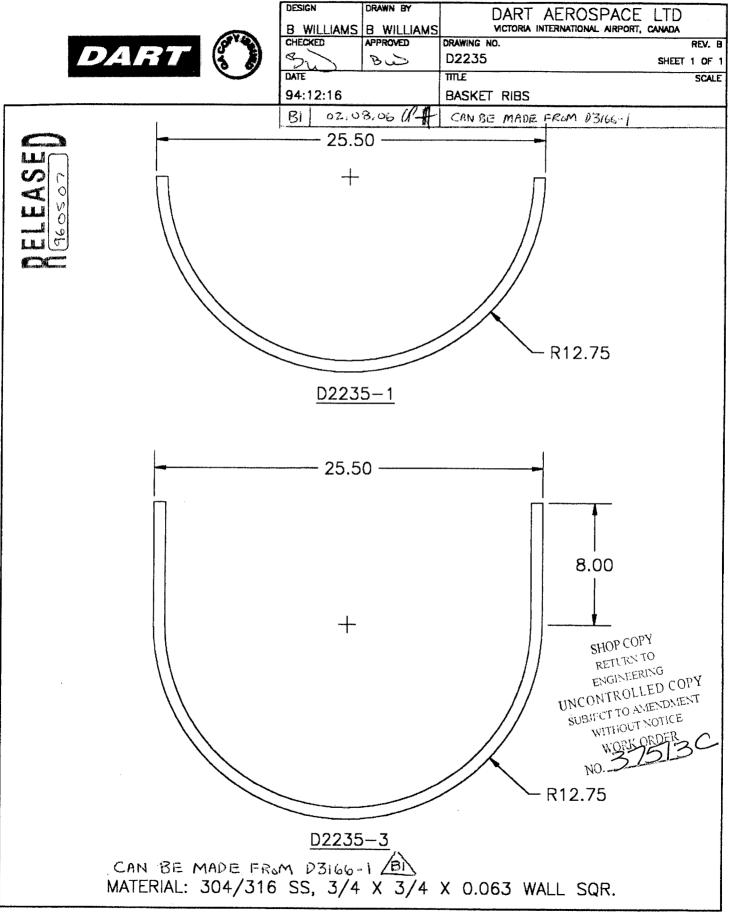

4.					
			•		
		•			
1					
- - -					
	,				
ą.					*
		·			
					·
	•				
				·	x + · ·
	The state of the s				